

**STATE OF UTAH**  
**DEPARTMENT OF NATURAL RESOURCES**  
**DIVISION OF OIL, GAS AND MINING**  
 1594 West North Temple - Suite 1210  
 Box 145801  
 Salt Lake City, Utah 84114-5801  
 Telephone: (801) 538-5291  
 Fax: (801) 359-3940

**LARGE MINING OPERATIONS PROGRESS REPORT**  
**January 1, 2015 to December 31, 2015**

The information required in this form is based on provisions of the Mined Land Reclamation Act, Title 40-8, and the R647 rules under the Utah Minerals Regulatory Program.

1. Mine Permit Number: M/051/0013
2. Mine Name: Center Creek Quarry
3. Name of Operator/Permittee: Geneva Rock Products, Inc.

Note: If Operator's address, company representative or phone number have changed, please provide a replacement page for the Notice of Intention together with form MR-REV available on the Division's web page at [https://fs.ogm.utah.gov/pub/mines/minerals\\_related/forms/MR-REV.pdf](https://fs.ogm.utah.gov/pub/mines/minerals_related/forms/MR-REV.pdf).

4. Report the gross amount of ore mined and waste moved:

Gross Ore Mined 264 Tons, or \_\_\_\_\_ yd<sup>3</sup>  
 Waste Material Moved 0 Tons, or \_\_\_\_\_ yd<sup>3</sup>

5. Disturbance at the end of 2014 13.00 Acres
- New Disturbance Created during 2015 0 Acres
- Area Reclaimed and Fully Released during 2015 0 Acres
- Total Disturbed Area at the end of 2015 13.00 Acres\*
- Permitted/Bonded Acreage 64.00 Acres


\*The total disturbed area should not be greater than the permitted/bonded acreage

6. Briefly describe the reclamation work performed during the past year. (Submit form MR-SITE ([https://fs.ogm.utah.gov/pub/mines/minerals\\_related/forms/MR-SITE.pdf](https://fs.ogm.utah.gov/pub/mines/minerals_related/forms/MR-SITE.pdf)) to apply for full or partial bond/site release). Attach additional sheets if needed.

No reclamation work has been performed during this period.

7. For large mines, include an updated map depicting surface disturbance and reclamation performed during the year (Rule R647-4-105).

**I hereby certify, under penalties of law, the information provided in this report is true and correct to the best of my knowledge and belief.**

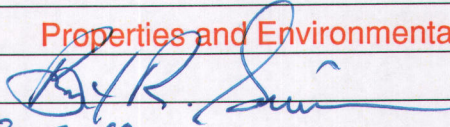
Name (Typed or Print): Brent R. Sumsion  
 Title of Operator: Properties and Environmental Manager  
 Signature of Operator:   
 Date: Jan. 28, 2016

pb

O:\FORMS\reports\MR-AR-LMO2010.doc


RECEIVED  
 JAN 28 2016  
 DIV. OF OIL, GAS & MINING



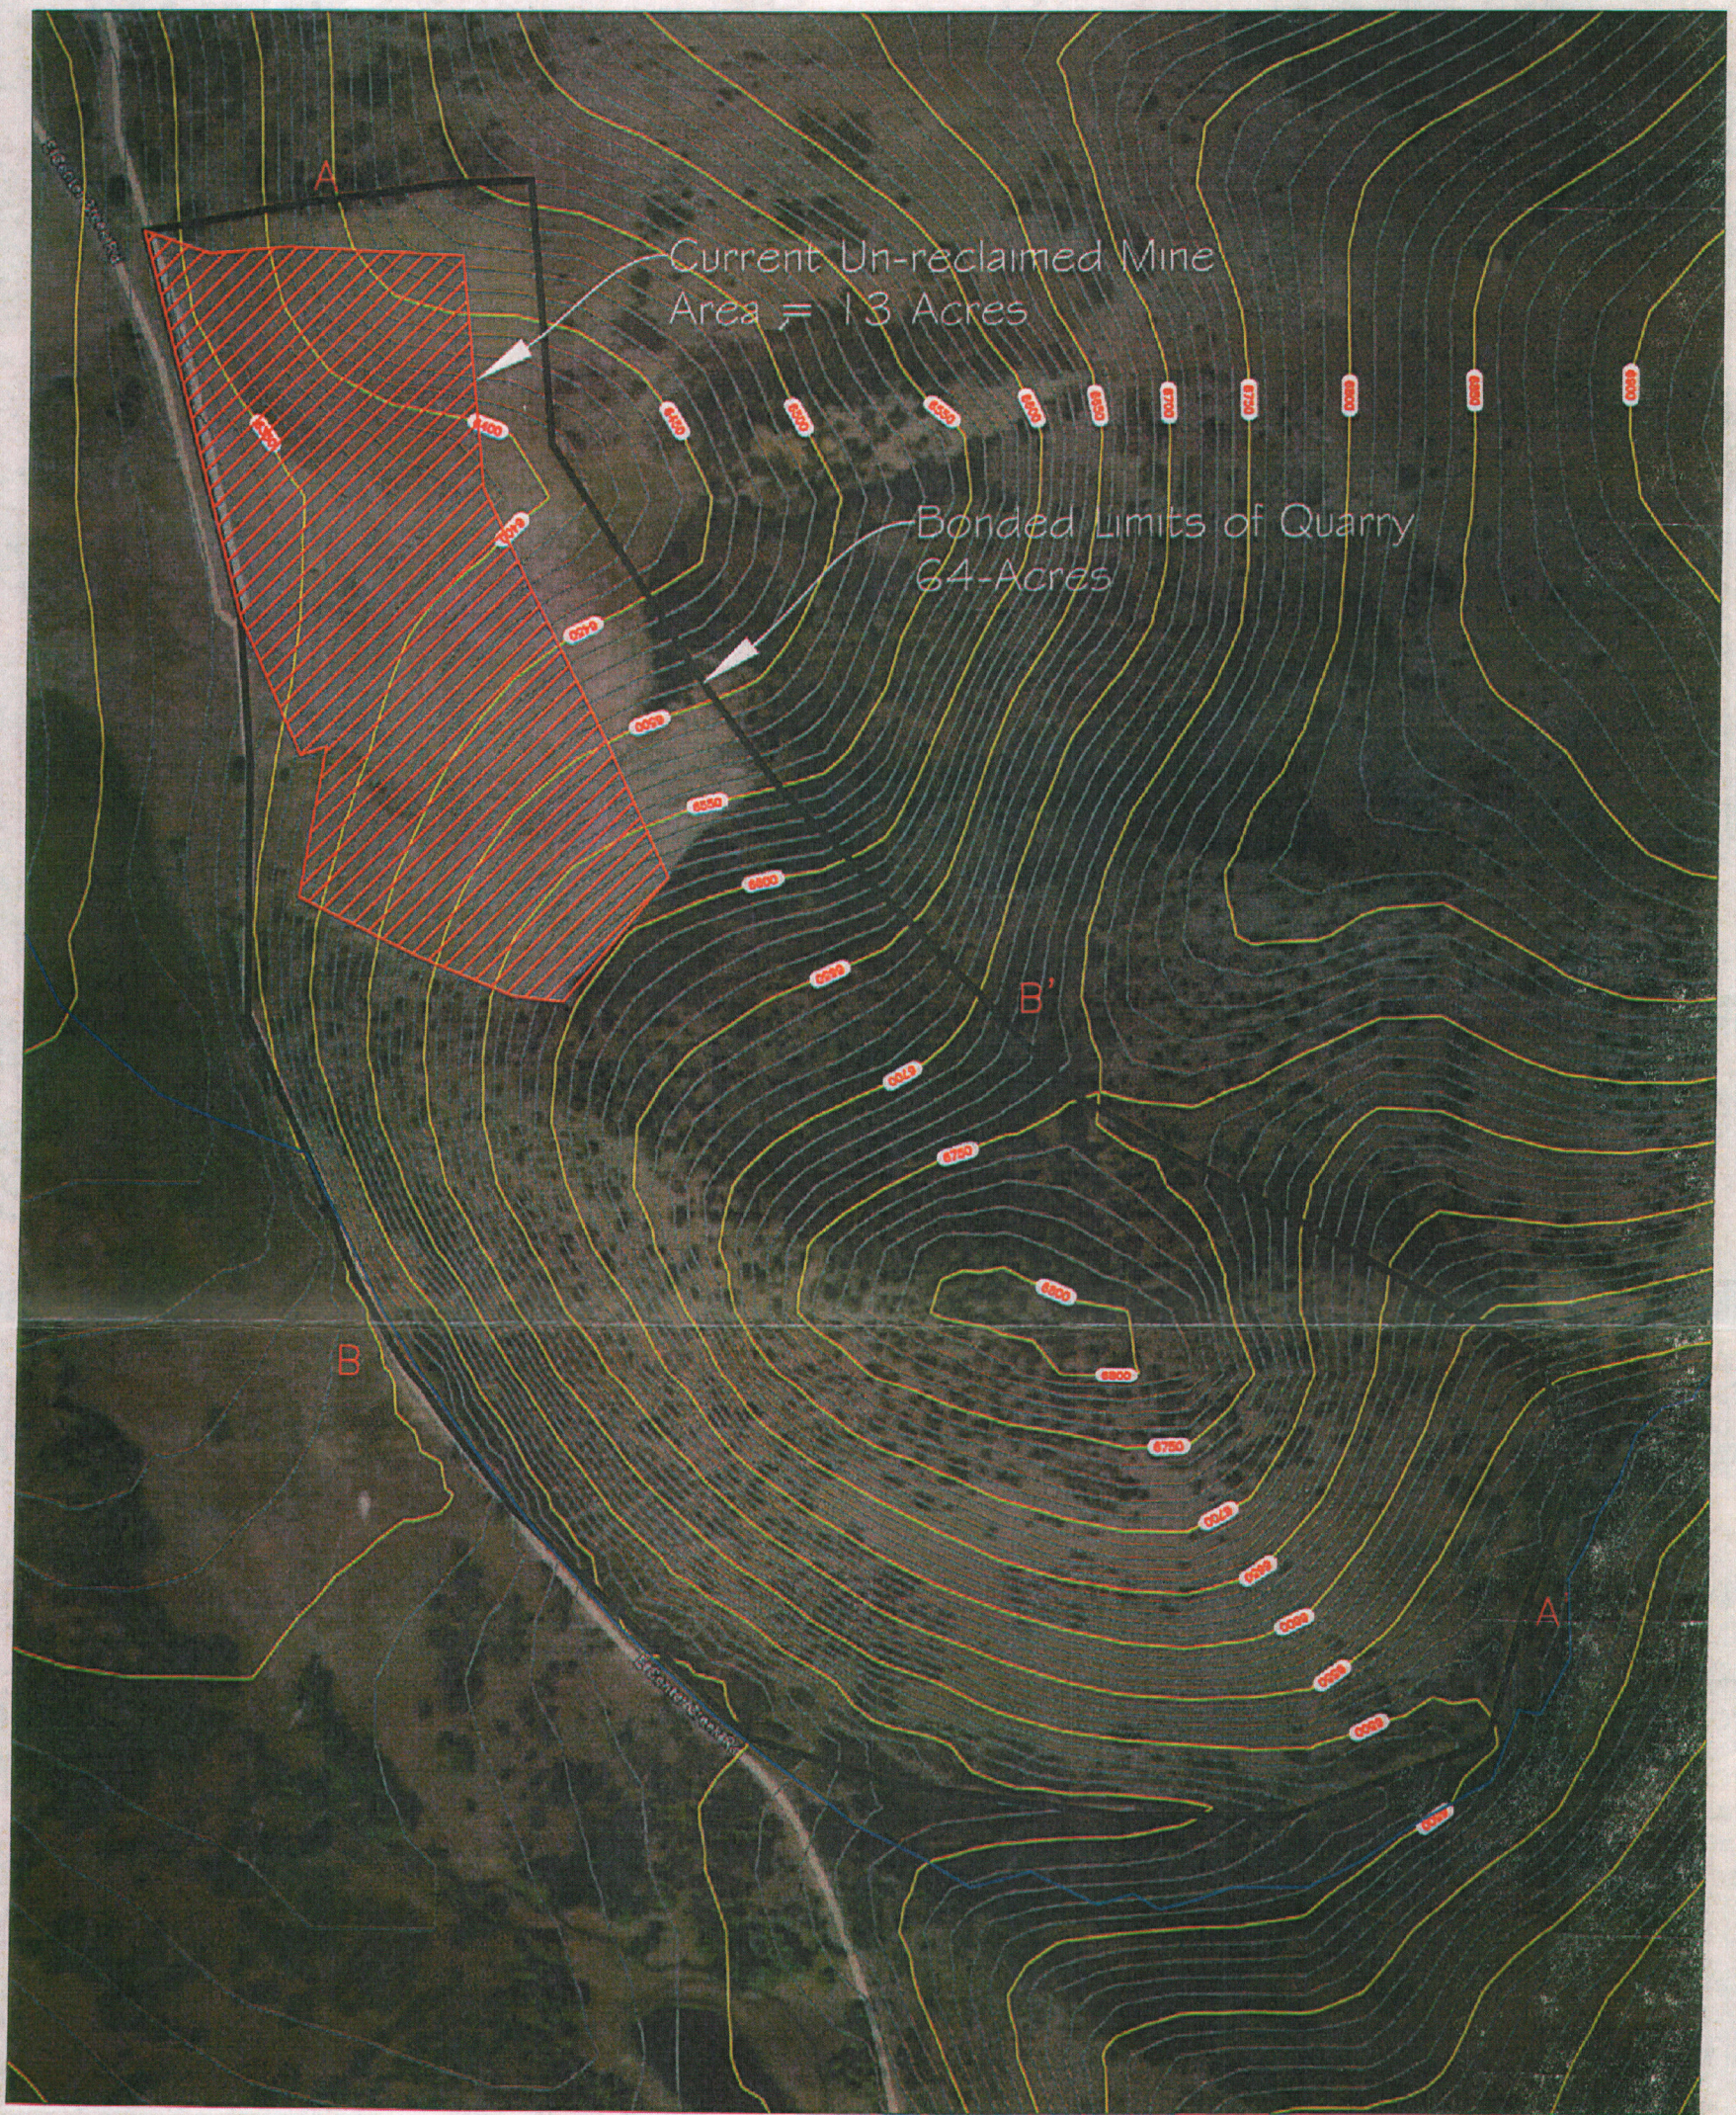


### Legend

Major 50' Contour  
 Minor 10' Contour  
 Water Course  
 Quarry Bdy  
 Existing Mine Footprint

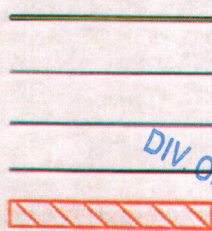


RECEIVED  
 JAN 28 2016  
 DIV OF OIL, GAS & MINING

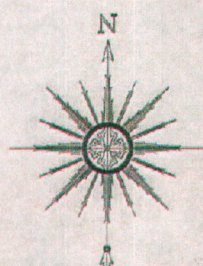

Scale 1"=300'

Drawn: B SUMSON	TITLE: Center Creek Quarry DOGM NOI Figure 3	Engineer:	
Checked: BS/CC			
Approved:			
Date: 1/28/16	ISSUED FOR INTERNAL REVIEW	Revision: 00	
Dwg. No.		NO.	DATE: DESCRIPTION: BY:

Geneva Rock Center Creek Quarry  
Original Contours



Geneva Rock Products, Inc.  
1556 West 400 North  
Orem, Utah 84057  
801-765-7800